



SERVICE NOTE

EFFECT: SUBROC-3D

NUMBER: 001

There have been some errors identified in the SUBROC-3D Owner's Manual (P/N 420-0822). Please correct your documentation as follows:

- On page 35 and 36, change the upper right-hand title to read;
ASSY COIN CHUTE DOOR UPRIGHT DRAWING NUMBER 834-0087
- On pages 60, 61 and 62, change the upper right-hand title to read;
COIN CHUTE DOOR ASSY COCKPIT DRAWING NUMBER 834-0397
- On page 60, ITEM NO. 15, correct the part number to read;

<u>ITEM NO.</u>	<u>PART NO.</u>	<u>QTY.REQ'D</u>	<u>DESCRIPTION</u>
15.	834-0413	1	Wire Harn Coin

FLIPPERS.COM

SEGA Electronics, Inc., 16250 Technology Drive, San Diego, CA. 92127-1985

Toll-free technical assistance inside CA. 1-800-722-8576

Toll-free technical assistance outside CA. 1-800-854-1938



SERVICE NOTE


EFFECT: SUBROC-3D

NUMBER: 002

An error has been found on page 140 of your SUBROC-3D Owner's Manual (P/N 420-0822), CPU Board sheet 2, Drawing No. 834-0358, Zone C-3. Please correct your schematic as indicated:

IS:

WAS:

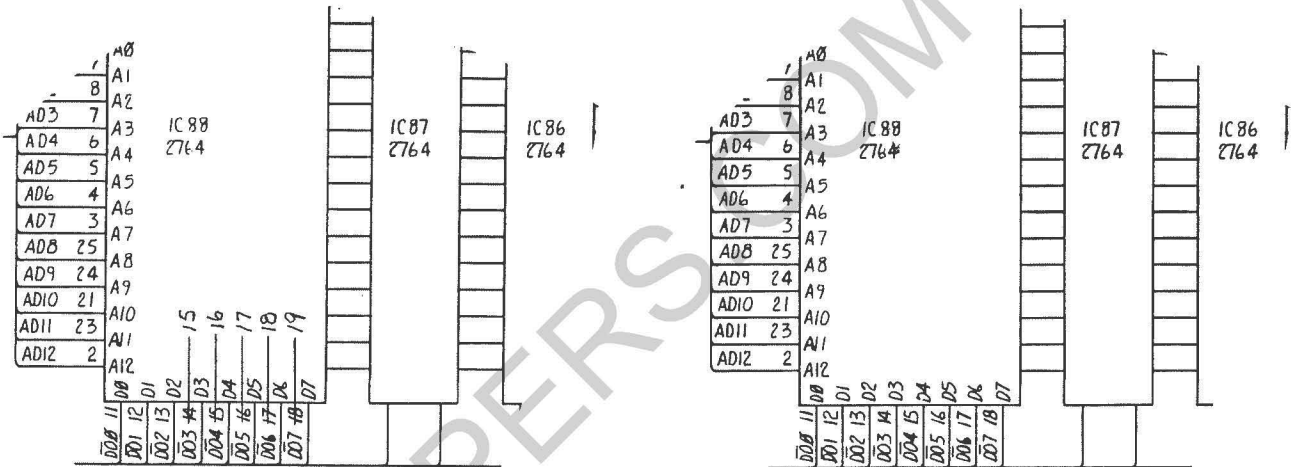



16250 Technology Drive
San Diego, California 92127-1895
(619) 485-0910

SERVICE NOTE

TOLL-FREE NUMBERS

Technical Assistance (800) 854-1938
Parts Assistance (800) 854-1900
California-Only Technical (800) 722-8576
California-Only Parts (800) 722-8575

PRIORITY:

- Urgent
 Upon Game Failure
 For Information Only

DATE: 3-23-83

GAME/ASSEMBLY

AFFECTED: SUBROC-3D™

NUMBER: 006

An omission has been found in your SUBROC-3D™ Owner's Manual (P/N 420-0822), page 70, ASSY SHUTTER, DRAWING NUMBER 834-0346. Please add the Item No. 6 information listed here, as well as the parts list on the following page to your Manual:

<u>ITEM NO.</u>	<u>PART NO.</u>	<u>QTY REQD.</u>	<u>DESCRIPTION</u>
6	834-5208	1	IC Shutter Board Assembly

FLIPPERS.COM



16250 Technology Drive
San Diego, California 92127-1895
(619) 485-0910

SERVICE NOTE

TOLL-FREE NUMBERS

Technical Assistance (800) 854-1938
Parts Assistance (800) 854-1900
California-Only Technical (800) 722-8576
California-Only Parts (800) 722-8575

PRIORITY:

- Urgent
- Upon Game Failure
- For Information Only

DATE: 4-15-83

GAME/ASSEMBLY

AFFECTED: SUBROC-3D™

NUMBER: 83-009

SUBJECT: SUBROC-3D™ Sound Board (P/N 834-0246)

PROBLEM: No audio output

ACTION: When re-installing the IC Board Assembly (P/N 834-0357) into either Upright or Cockpit models, be sure to verify that Sound Board connectors CN2 and CN3 have been replaced. These are two small Molex connectors (5-pin and 3-pin, respectively), that due to their position on the Sound Board, are easily missed underneath the PROM Board in the IC Board Assembly.

FLIPPERS.COM